



James R. Gill

BUILDING
262,710 sq. ft.



STAFFORD ROAD

AIRTECH PARKWAY

AIRTECH PARKWAY

FUTURE DRIVE

File Path \Name: I:\Jobs\2017\17112-HSA Stafford Road\Drawings\Exhibits\Asbuilt Exhibit.dwg - Date: Apr 09, 2019 - 10:42am

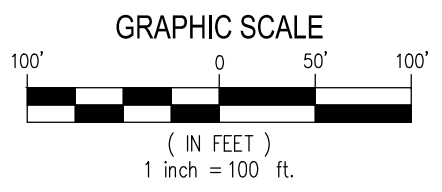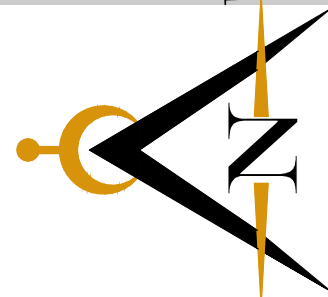

GATEWAY BUILDING 5 AS-BUILT BUILDING EXHIBIT



Innovative
ENGINEERING & CONSULTING

3961 Perry Boulevard
Ph. 317-769-2916

Whitestown, IN 46075
www.innovativeeci.com